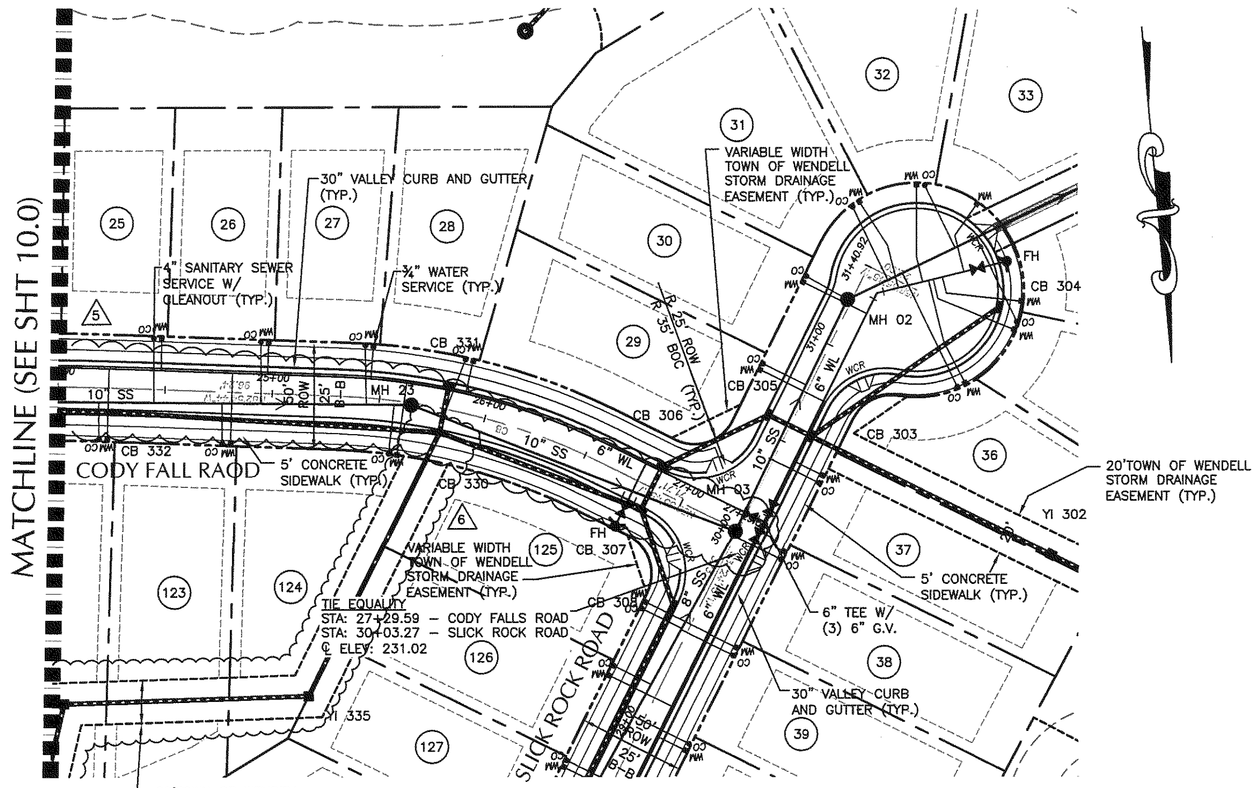

CODY FALLS ROAD

SCALE: 1"=50'

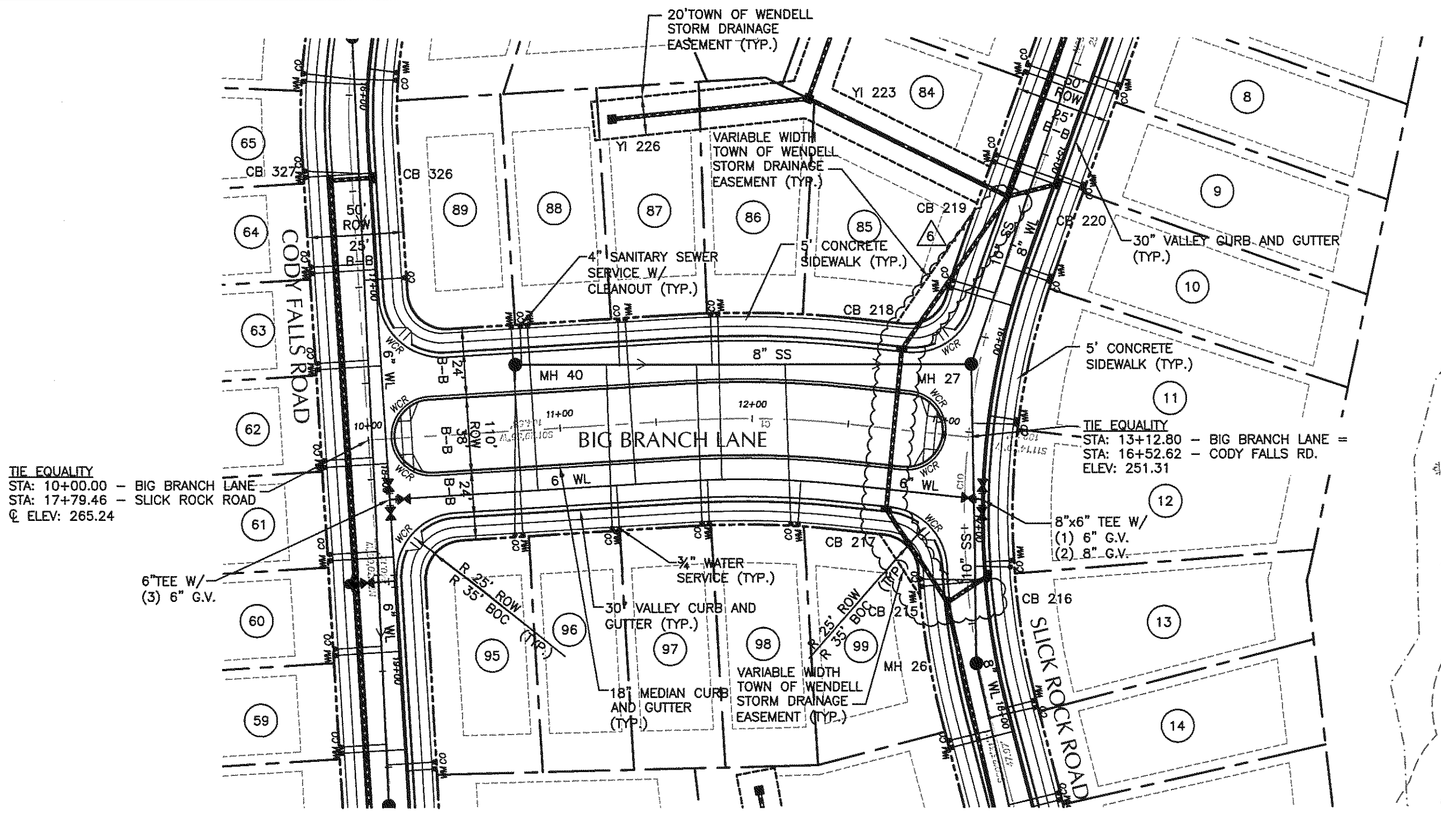

BIG BRANCH LANE

SCALE: 1"=50'

CURVE TABLE				
CURVE	CHORD LENGTH	CHORD BEARING	LENGTH	RADIUS
C1	84.94'	N06°22'17"E	85.05	500.00
C2	21.73'	S05°53'15"W	21.74	275.00
C3	35.98'	S11°54'12"W	36.01	275.00
C4	326.25'	S64°20'37"W	344.94	300.00
C5	20.98'	N79°50'39"W	20.98	300.00
C6	231.32'	S83°10'16"E	231.66	1245.00
C7	429.56'	N37°08'48"W	492.97	275.00
C8	126.37'	S70°45'14"E	127.32	300.00
C9	588.00'	N88°44'24"E	590.08	2025.00
C10	236.53'	N82°24'19"W	240.12	400.00
C11	87.57'	S70°30'11"E	87.70	475.00

THESE PLANS HAVE BEEN APPROVED FOR CONSTRUCTION BY THE TOWN OF WENDELL

ZONING / SUBDIVISION ADMINISTRATOR — DATE 1-18-08

TOWN OF WENDELL FIRE CHIEF — DATE 1-20-08

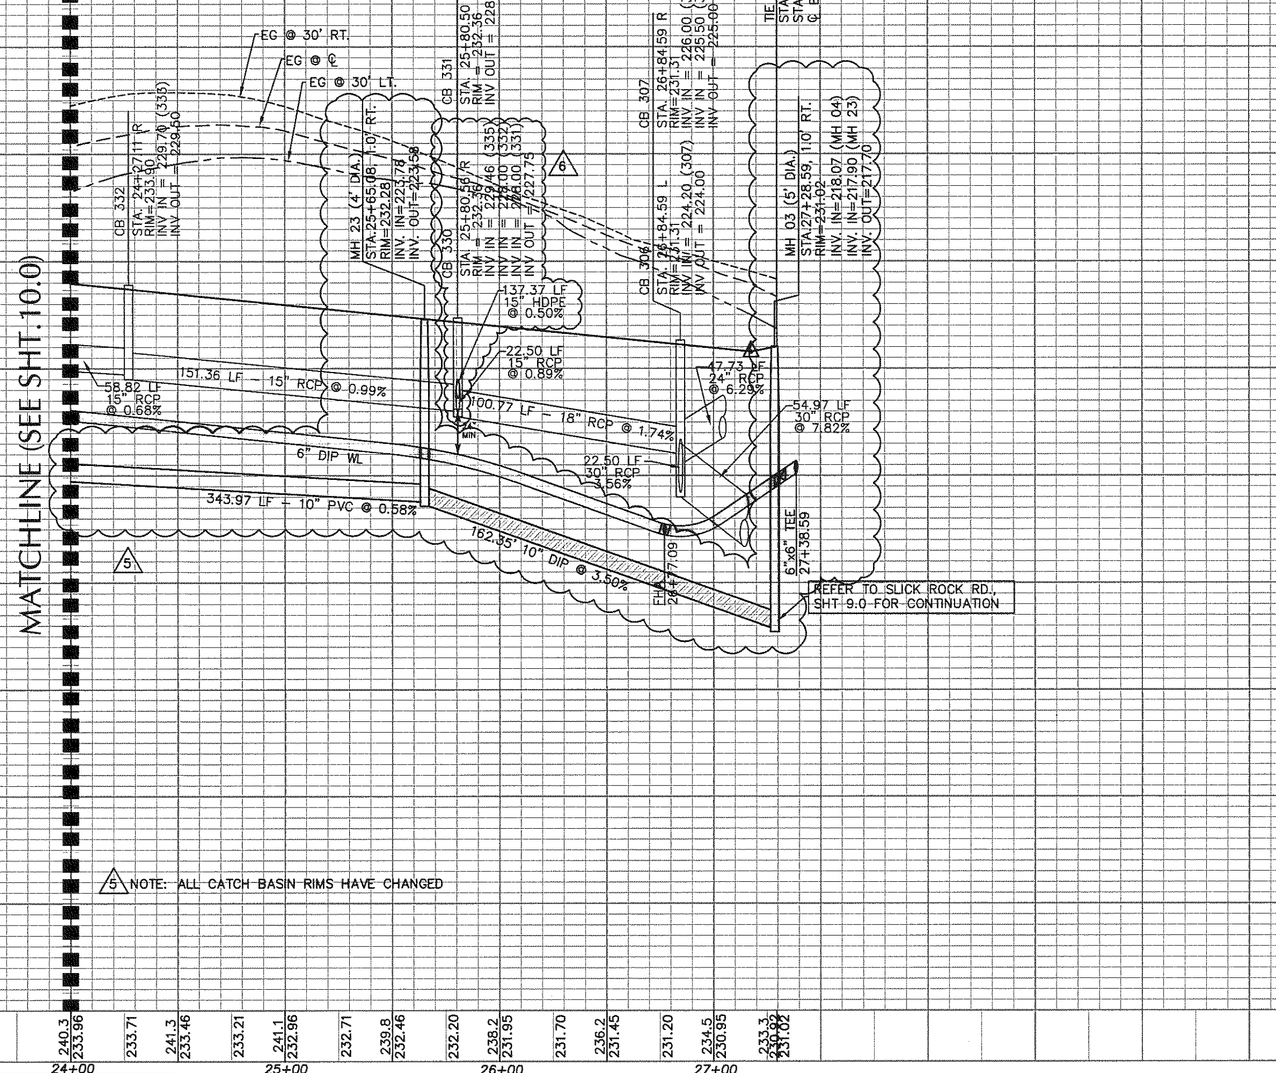

CODY FALLS ROAD

SCALE: HORIZONTAL 1"=50'
VERTICAL 1"=5'

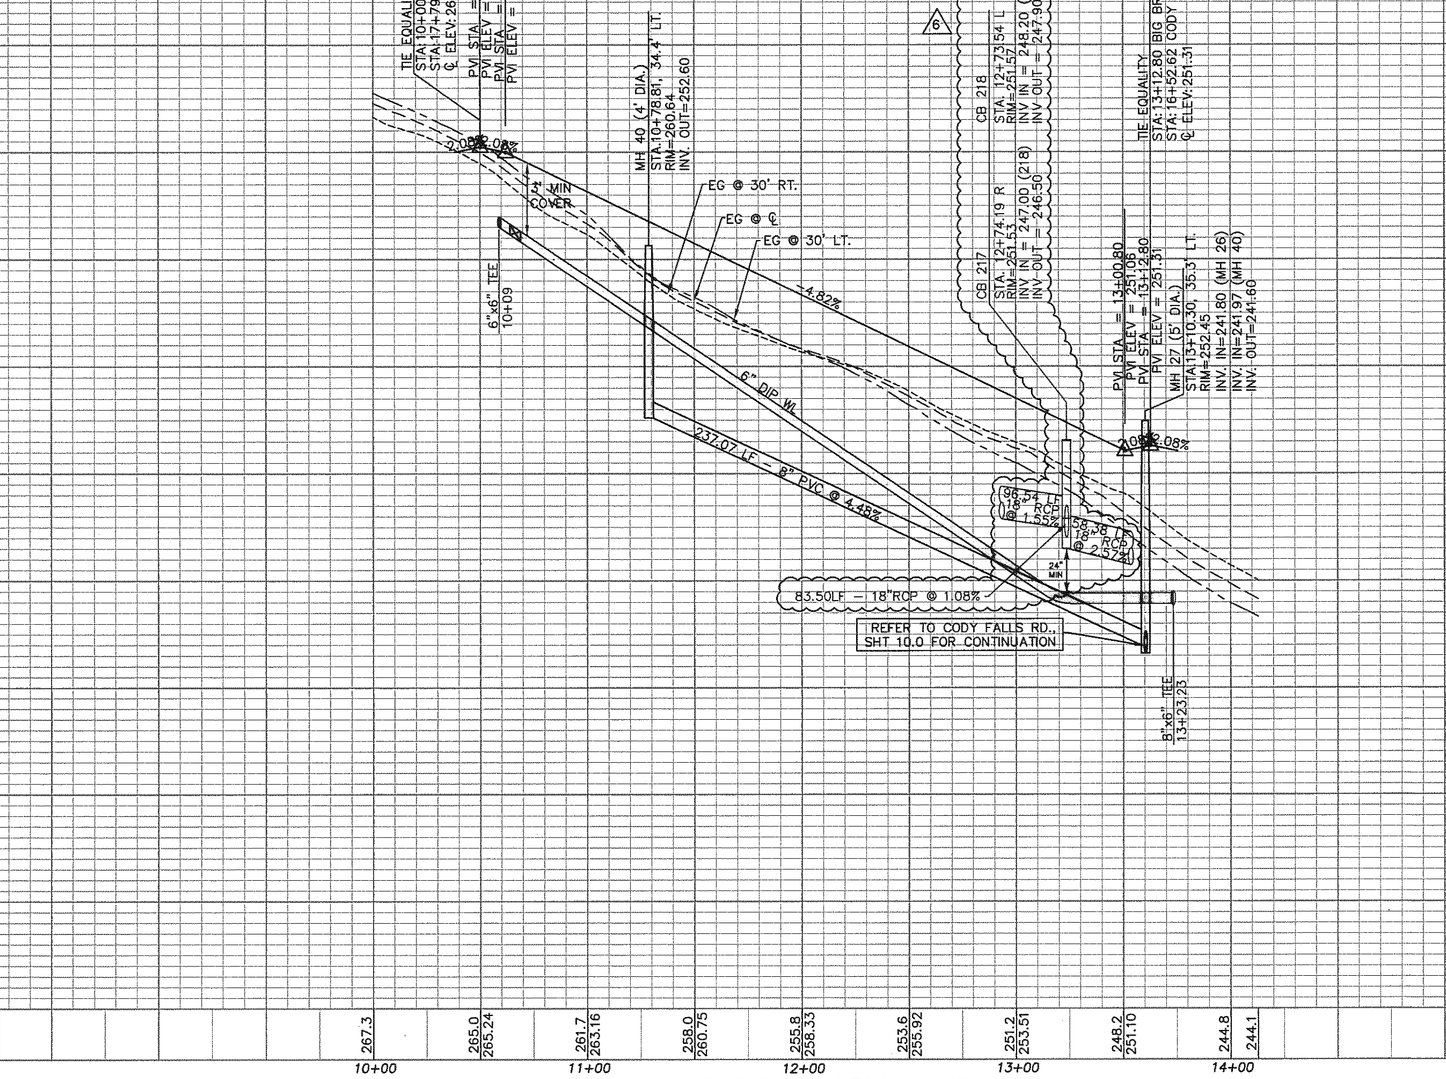

BIG BRANCH LANE

SCALE: HORIZONTAL 1"=50'
VERTICAL 1"=5'

No.	Revision	Date	By
6	PULTE REVISIONS	12/21/07	JAC

CONSTRUCTION SPECIFICATIONS

PUBLIC
Sewer Collection/Extension System

The City Raleigh consents to the connection and extension of the City's public sewer system as shown on this plan. The material and construction methods used for this project shall conform to the standards and specifications of the City's Public Utilities Handbook.

City of Raleigh Public Utilities Department Permit # S-3096 (REV.)

Authorization to Construction — Date 1/24/08

CONSTRUCTION SPECIFICATIONS

PUBLIC
Water Distribution/Extension System

The City Raleigh consents to the connection and extension of the City's public water system as shown on this plan. The material and construction methods used for this project shall conform to the standards and specifications of the City's Public Utilities Handbook.

City of Raleigh Public Utilities Department Permit # W-2553 (REV.)

Authorization to Construction — Date 1/24/08

NORTH CAROLINA PROFESSIONAL SEAL 18498 ENGINEER KENNETH L. JESNICK

11/7/08

No.	Revision	Date	By
1	FIRST REVIEW COMMENTS	03/07/07	SFP
2	PER TOW & COR COMMENTS	04/25/07	JAC
3	MYLAR	05/10/07	DLP
4	GRADING AND DRAINAGE REVISIONS	08/10/07	JAC
5	REGRADE & STORM/SS REVISIONS	10/10/07	JEW

Designer	KAP
Scale	1" = 50'
Drawn By	RSM
Date	12/07/06
Checked By	W&R
Job No.	205261.04

WENDELL FALLS SF-1

Wendell — Wake County — North Carolina

PLAN & PROFILE
CODY FALLS ROAD & BIG BRANCH LANE

WITHERS & RAVENEL
ENGINEERS I PLANNERS I SURVEYORS
111 MacKenan Drive Cary, North Carolina 27511 tel: 919-469-3340 fax: 919-467-6008 www.withersravenel.com

Sheet No. 11.0

K:\05\05-260\05261.04\CAD\SF-1\CONST. PLANS\3rd Submittal\SHT 07-12-plan profiles.dwg– Wednesday, January 16, 2008 10:43:35 AM – JOHN CORE