| CURVE TABLE | | | | | |
|---|---|---|---|---|---|
| CURVE | CHORD LENGTH | CHORD BEARING | LENGTH | RADIUS |
| C1 | 84.94' | N06°22'17"E | 85.05 | 500.00 |
| C2 | 21.73' | S05°53'15"W | 21.74 | 275.00 |
| C3 | 35.98' | S11°54'12"W | 36.01 | 275.00 |
| C4 | 326.25' | S64°20'37"W | 344.94 | 300.00 |
| C5 | 20.98' | N75°50'39"W | 20.98 | 300.00 |
| C6 | 231.32' | S83°10'16"E | 231.66 | 1245.00 |
| C7 | 429.56' | N37°08'48"W | 492.97 | 275.00 |
| C8 | 126.37' | S70°45'14"E | 127.32 | 300.00 |
| C9 | 588.00' | N88°44'24"E | 590.08 | 2025.00 |
| C10 | 236.53' | N82°24'39"W | 240.12 | 400.00 |
| C11 | 87.57' | S70°30'11"E | 87.70 | 475.00 |

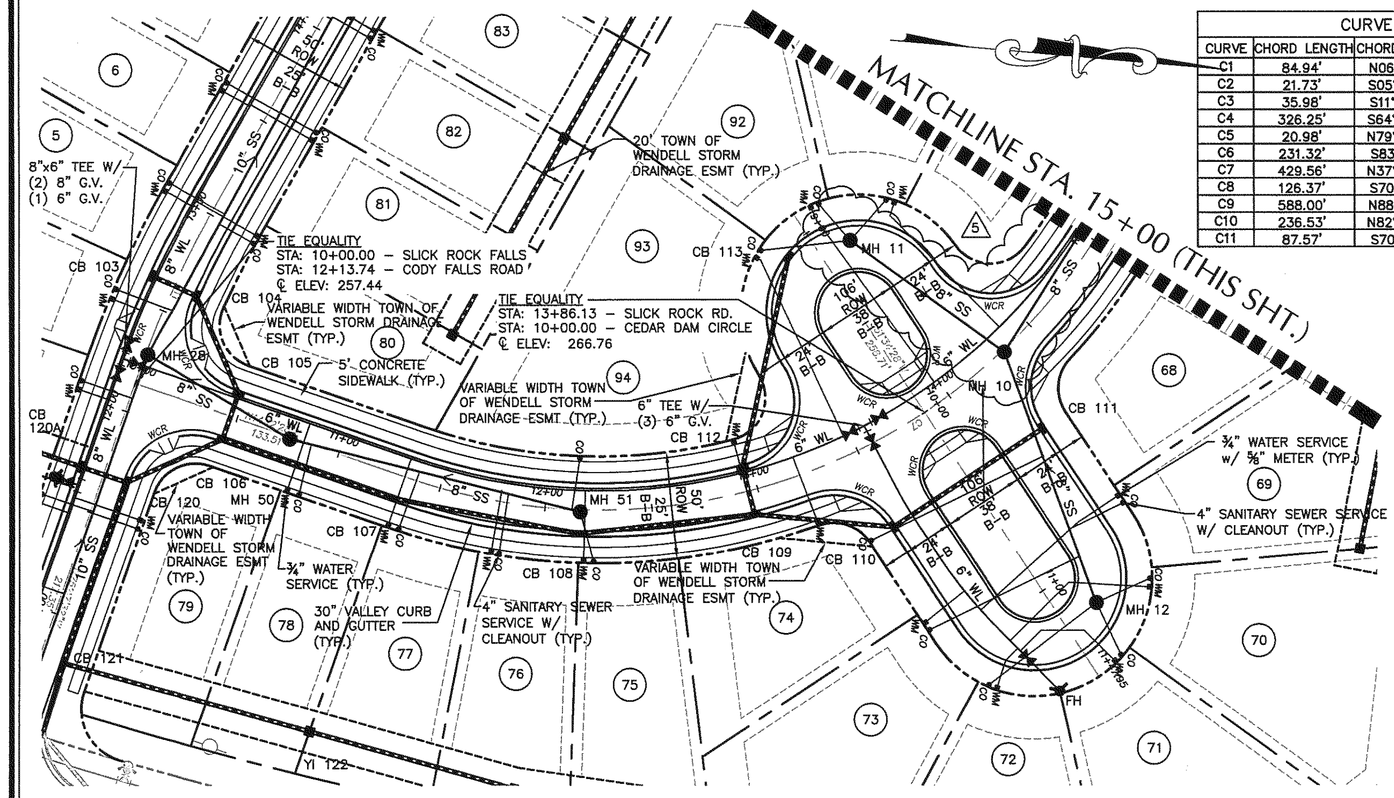


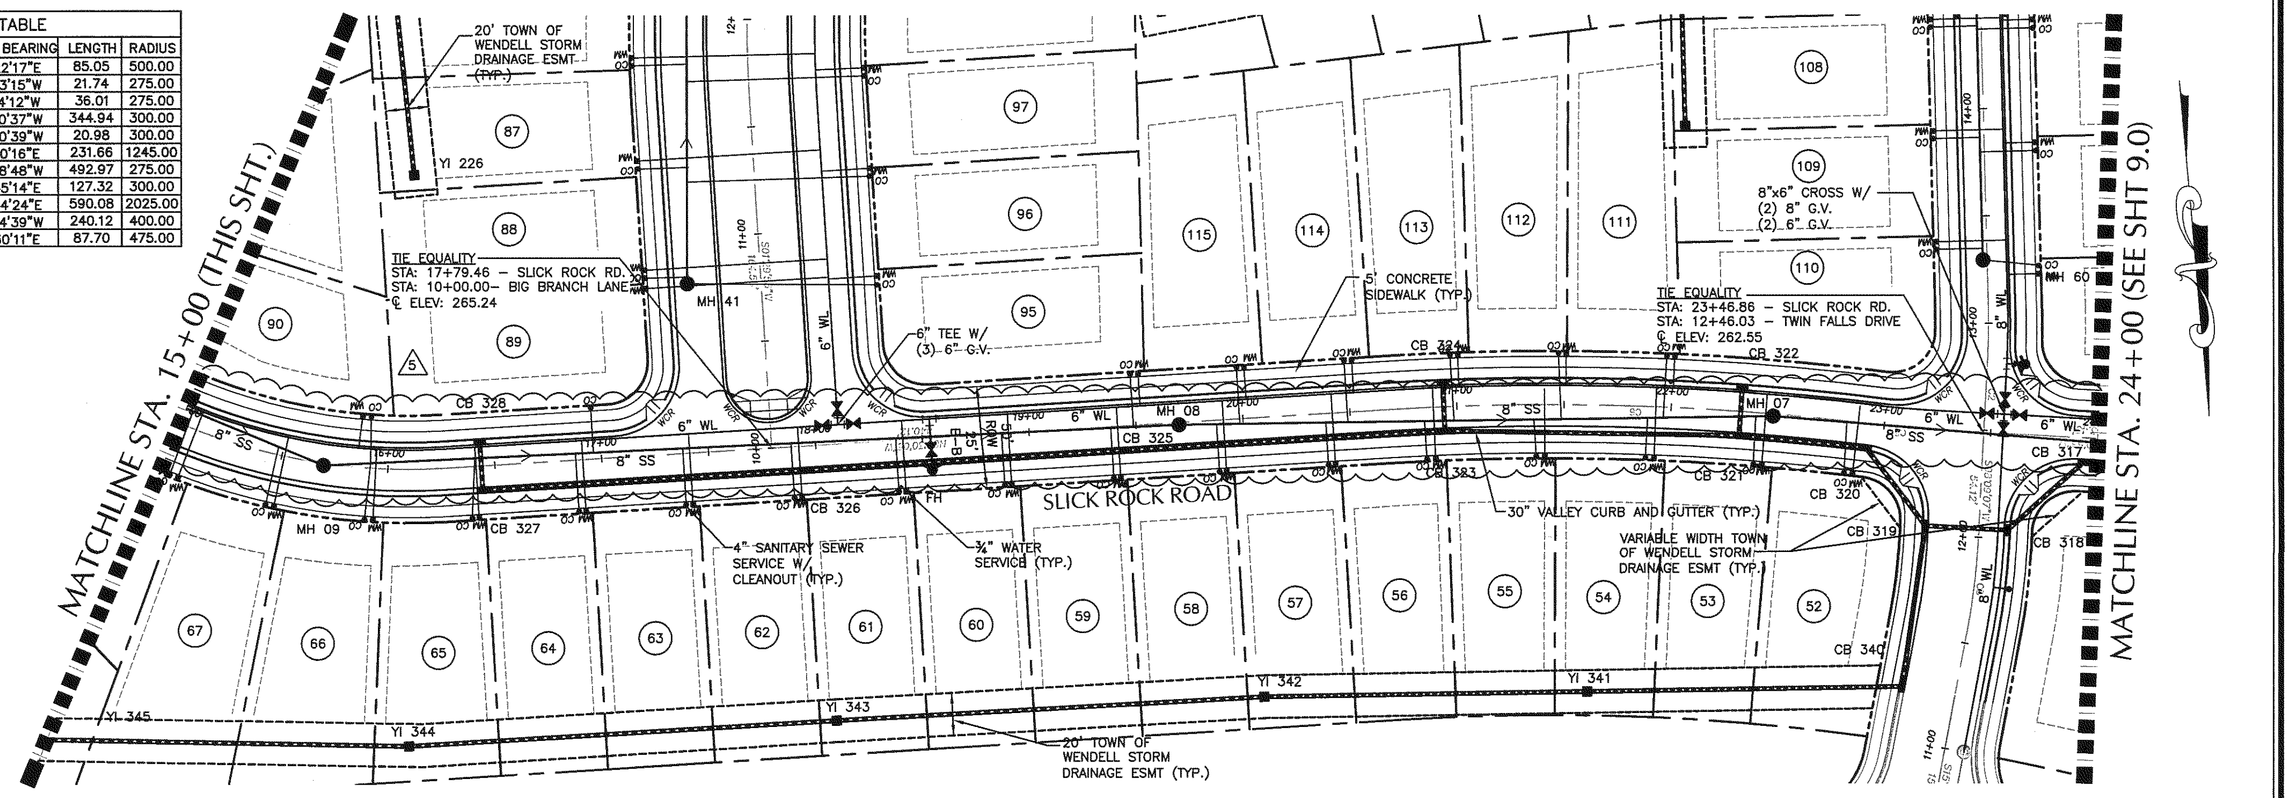


## SLICK ROCK ROAD
SCALE: 1"=50'

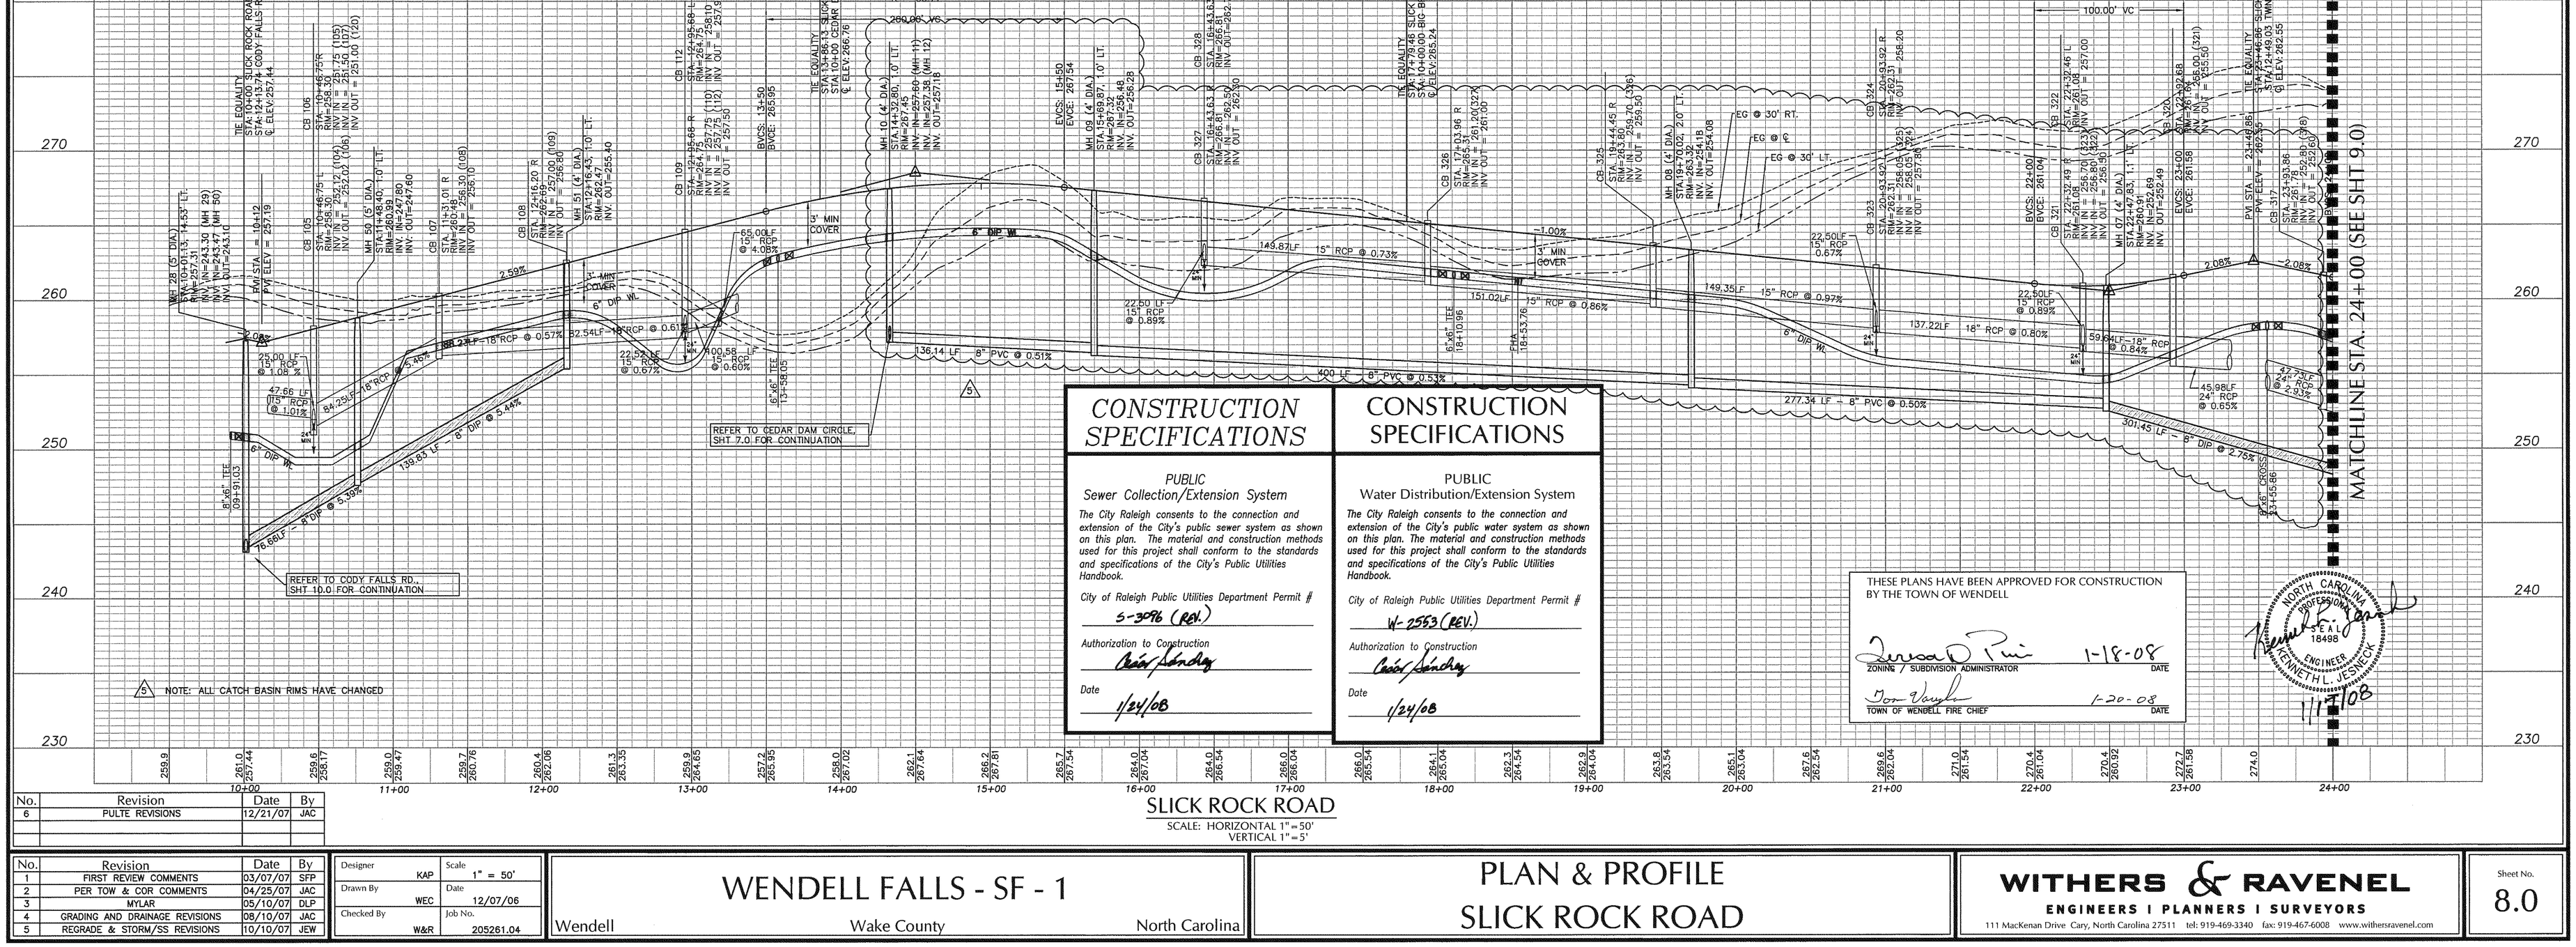


## SLICK ROCK ROAD
SCALE: HORIZONTAL 1"=50'
VERTICAL 1"=5'

NOTE: ALL CATCH BASIN RIMS HAVE CHANGED

| No. | Revision | Date | By |
|---|---|---|---|
| 6 | PULTE REVISIONS | 12/21/07 | JAC |

## CONSTRUCTION SPECIFICATIONS

PUBLIC
Sewer Collection/Extension System

*The City Raleigh consents to the connection and extension of the City's public sewer system as shown on this plan. The material and construction methods used for this project shall conform to the standards and specifications of the City's Public Utilities Handbook.*

*City of Raleigh Public Utilities Department Permit #*
S-3096 (REV.)

*Authorization to Construction*
Cecil Sandy

*Date*
1/24/08

## CONSTRUCTION SPECIFICATIONS

PUBLIC
Water Distribution/Extension System

*The City Raleigh consents to the connection and extension of the City's public water system as shown on this plan. The material and construction methods used for this project shall conform to the standards and specifications of the City's Public Utilities Handbook.*

*City of Raleigh Public Utilities Department Permit #*
W-2553 (REV.)

*Authorization to Construction*
Cecil Sandy

*Date*
1/24/08

THESE PLANS HAVE BEEN APPROVED FOR CONSTRUCTION BY THE TOWN OF WENDELL

Teresa D. Piner — ZONING / SUBDIVISION ADMINISTRATOR — 1-18-08 DATE

Don Vaughn — TOWN OF WENDELL FIRE CHIEF — 1-20-08 DATE

NORTH CAROLINA PROFESSIONAL SEAL 18498 ENGINEER KENNETH L. JESNECK — 1/17/08

| No. | Revision | Date | By |
|---|---|---|---|
| 1 | FIRST REVIEW COMMENTS | 03/07/07 | SFP |
| 2 | PER TOW & COR COMMENTS | 04/25/07 | JAC |
| 3 | MYLAR | 05/10/07 | DLP |
| 4 | GRADING AND DRAINAGE REVISIONS | 08/10/07 | JAC |
| 5 | REGRADE & STORM/SS REVISIONS | 10/10/07 | JEW |

| | |
|---|---|
| Designer | KAP |
| Drawn By | WEC |
| Checked By | W&R |
| Scale | 1" = 50' |
| Date | 12/07/06 |
| Job No. | 205261.04 |

# WENDELL FALLS - SF - 1
Wendell — Wake County — North Carolina

# PLAN & PROFILE
# SLICK ROCK ROAD


WITHERS & RAVENEL
ENGINEERS I PLANNERS I SURVEYORS
111 MacKenan Drive Cary, North Carolina 27511 tel: 919-469-3340 fax: 919-467-6008 www.withersravenel.com


Sheet No. 8.0

K:\05\05-260\05261.04\CAD\SF-1\CONST. PLANS\3rd Submittal\SHT 07-12-plan profiles.dwg, Wednesday, January 16, 2008 10:48:42 AM — JOHN CORE